




**NORTH ELEVATION**  
1 : 100

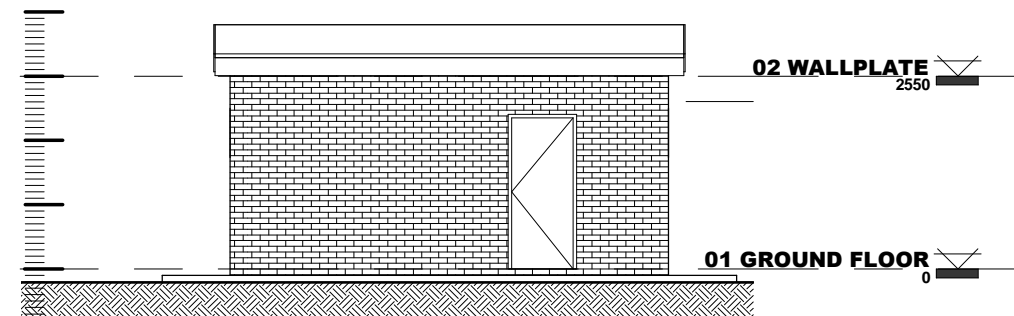


**SOUTH ELEVATION**  
1 : 100

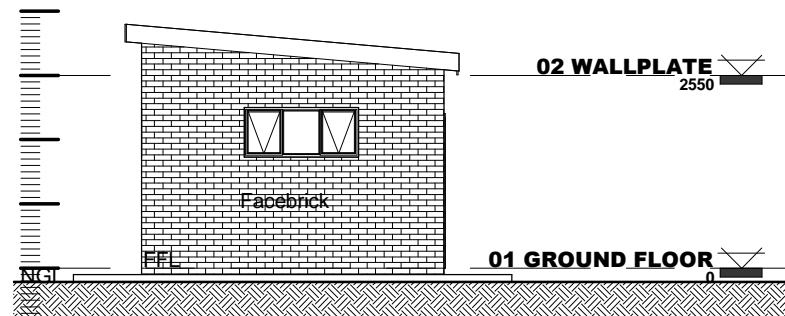


**EAST ELEVATION**  
1 : 100

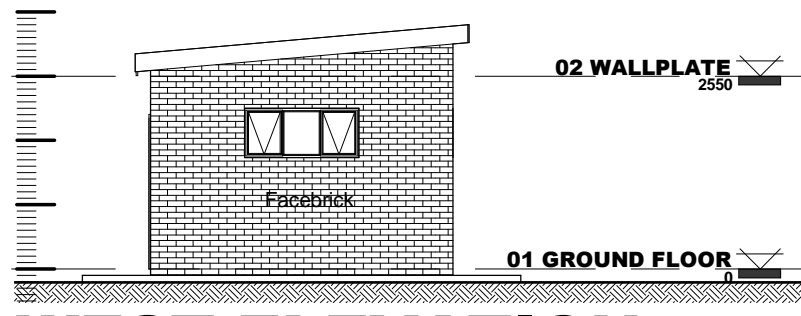



**WEST ELEVATION**  
1 : 100

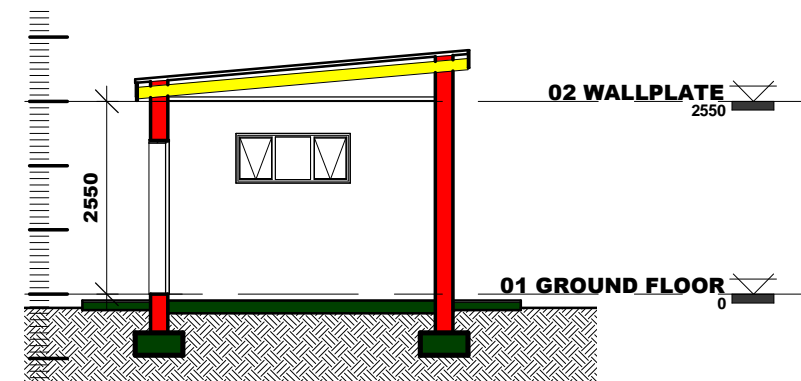

**SECTION A**  
1 : 100

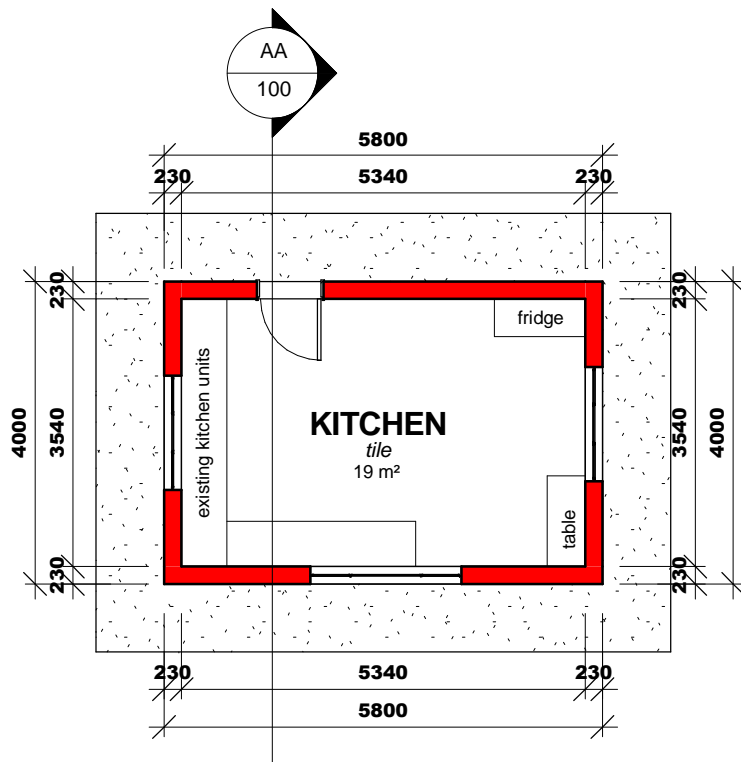

**GROUND FLOOR PLAN**  
1 : 100

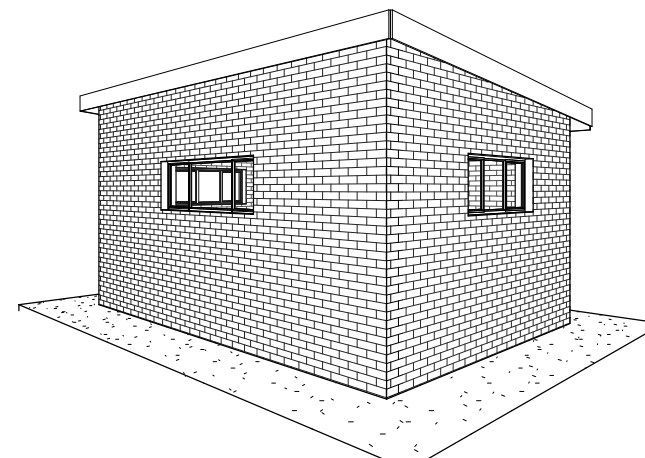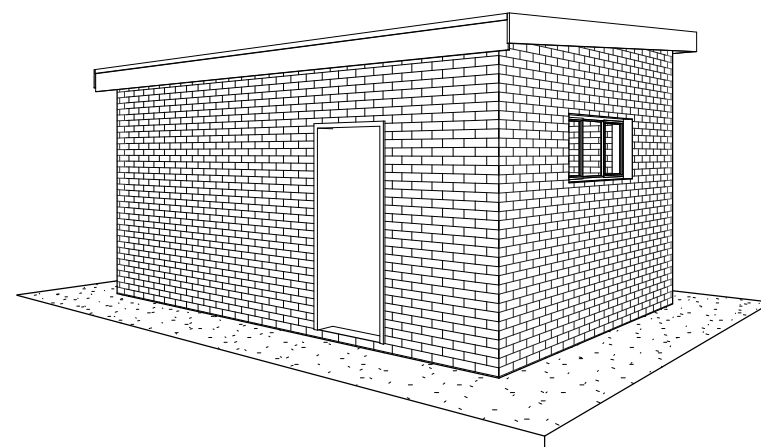

MMMIHA BUILDING AND PROJECTS 1 cc  
ARCHITECTURAL-CONSTRUCTION-PROJECT MANAGEMENT  
Reg: 2011/017173/23

Contact: 082 639 0982  
Email: tskyber@gmail.com

Client



**the gpa**  
Department:  
Government Pensions Administration Agency  
REPUBLIC OF SOUTH AFRICA

Client project number

Project Title

**KITCHEN & DINING AS-BUILT  
DRAWING**

Site Information

**GPAA PRETORIA**

Project Architect

Project Co-ordinator/ Manager

Project Architectural Technician

Thabiso Sekiba

Drawing title

**PLANS, SECTION,  
ELEVATIONS**

Project No <b>2016G</b>	Drawing No <b>100</b>	Project Stage <b>4</b>	Drawing Revision
Scale <b>1 : 100</b>	Drawn <b>TS</b>	Checked <b>RDM</b>	
First Issue Date <b>2016/06/28</b>	Latest Issue Date <b>2016/06/28 08:46:35 PM</b>		