




**NORTH ELEVATION**  
1 : 100

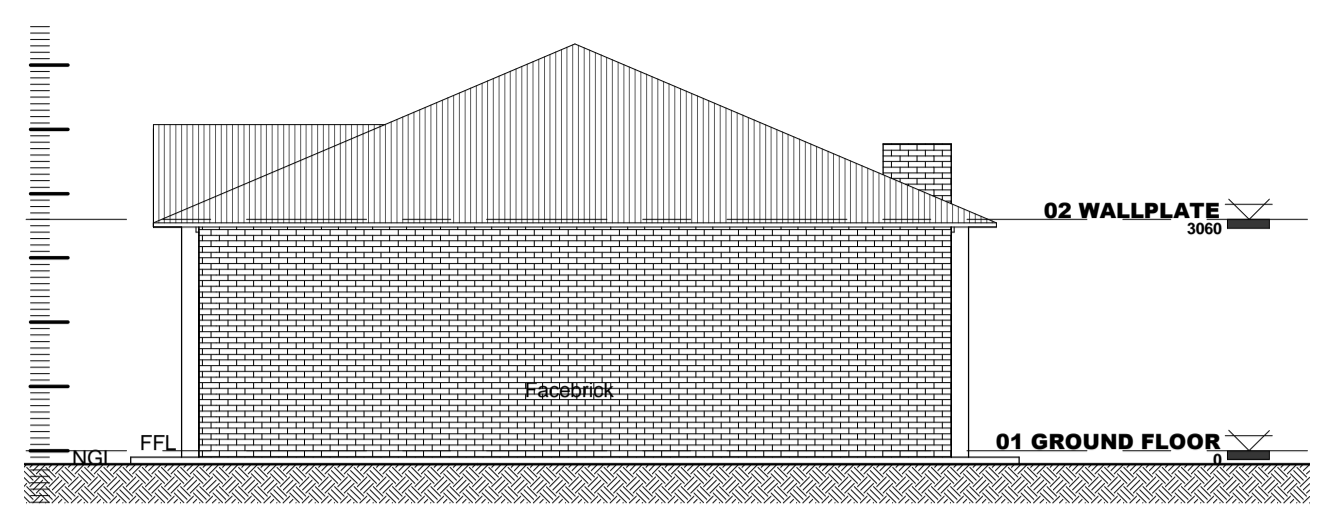


**EAST ELEVATION**  
1 : 100

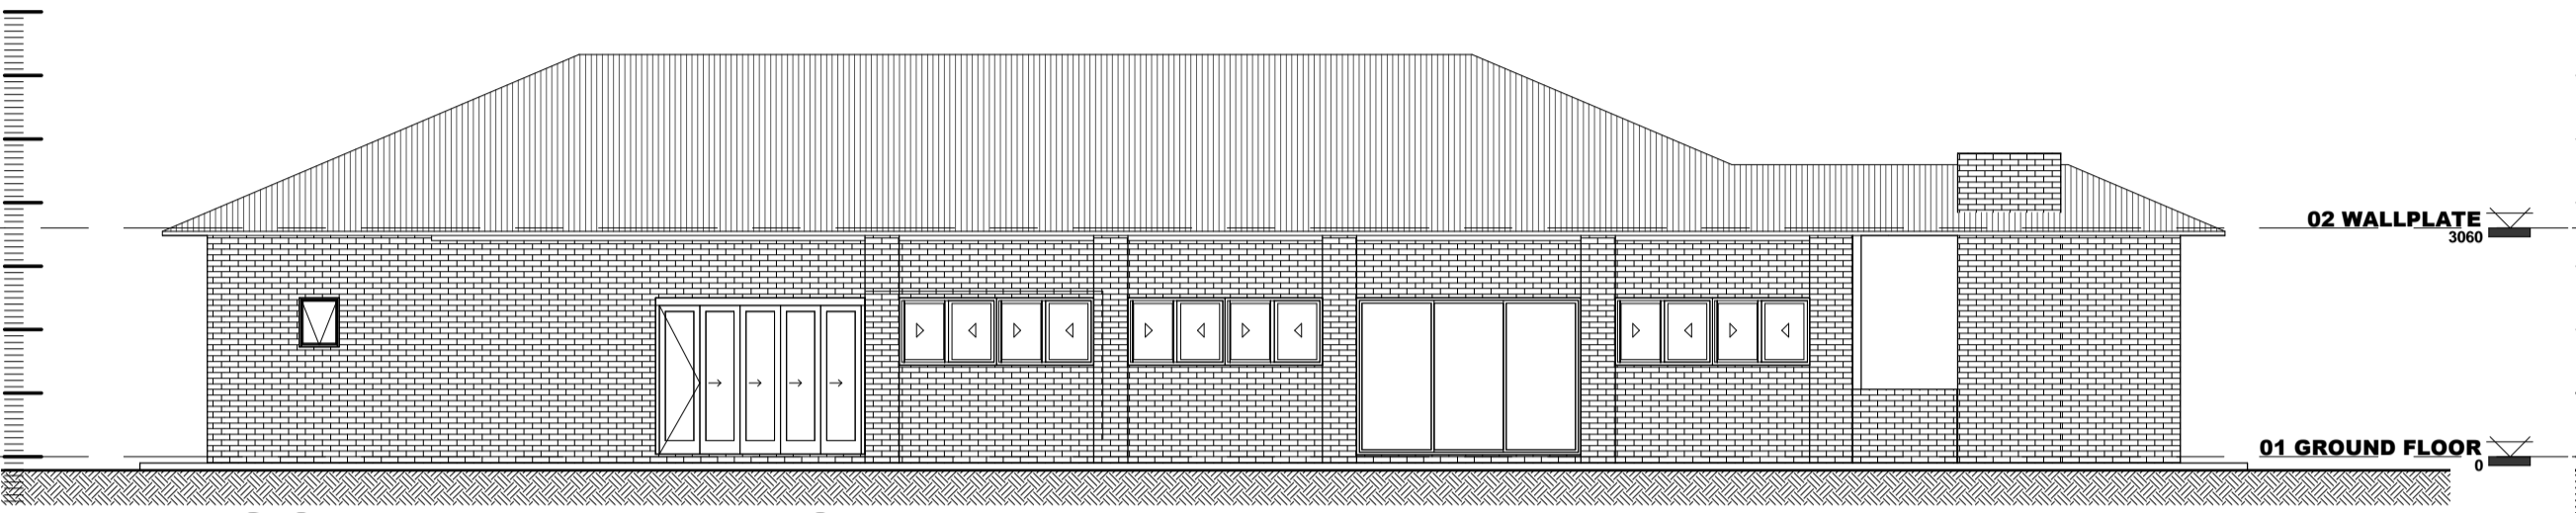




**SOUTH ELEVATION**  
1 : 100

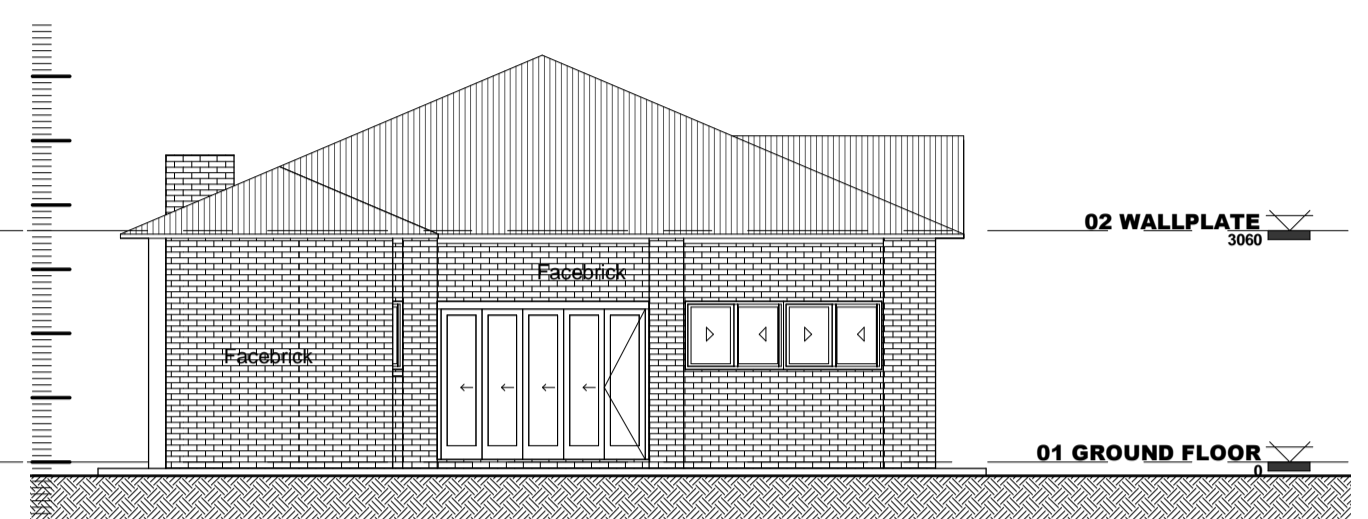


**WEST ELEVATION**  
1 : 100

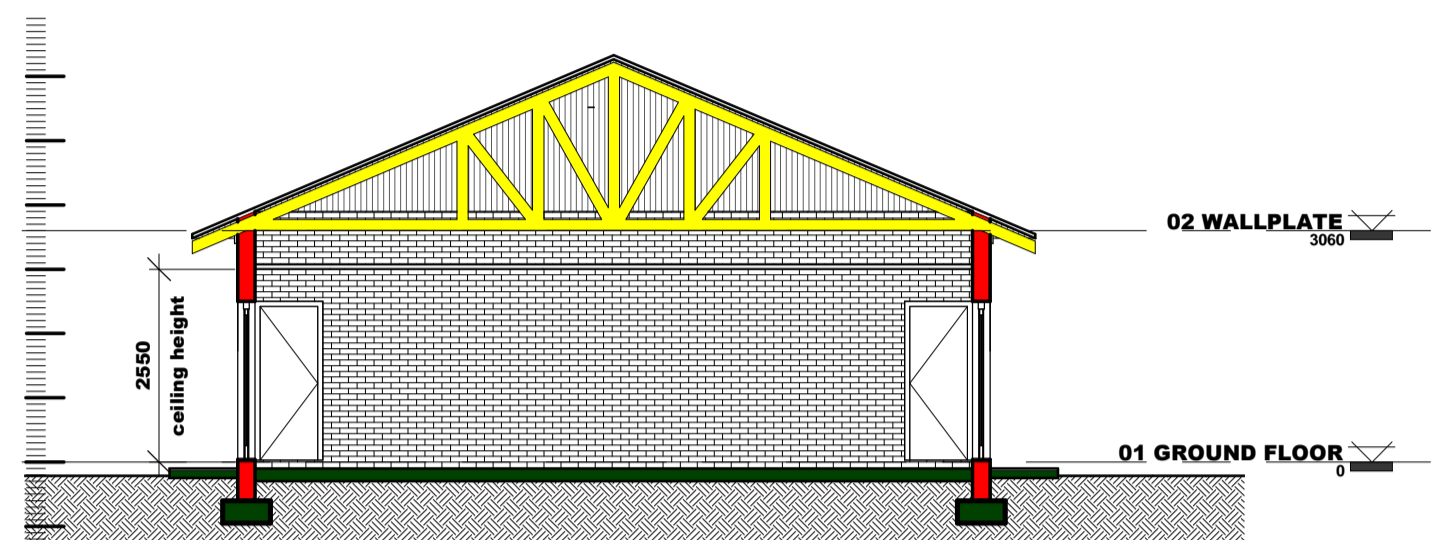

**SECTION A**  
1 : 100

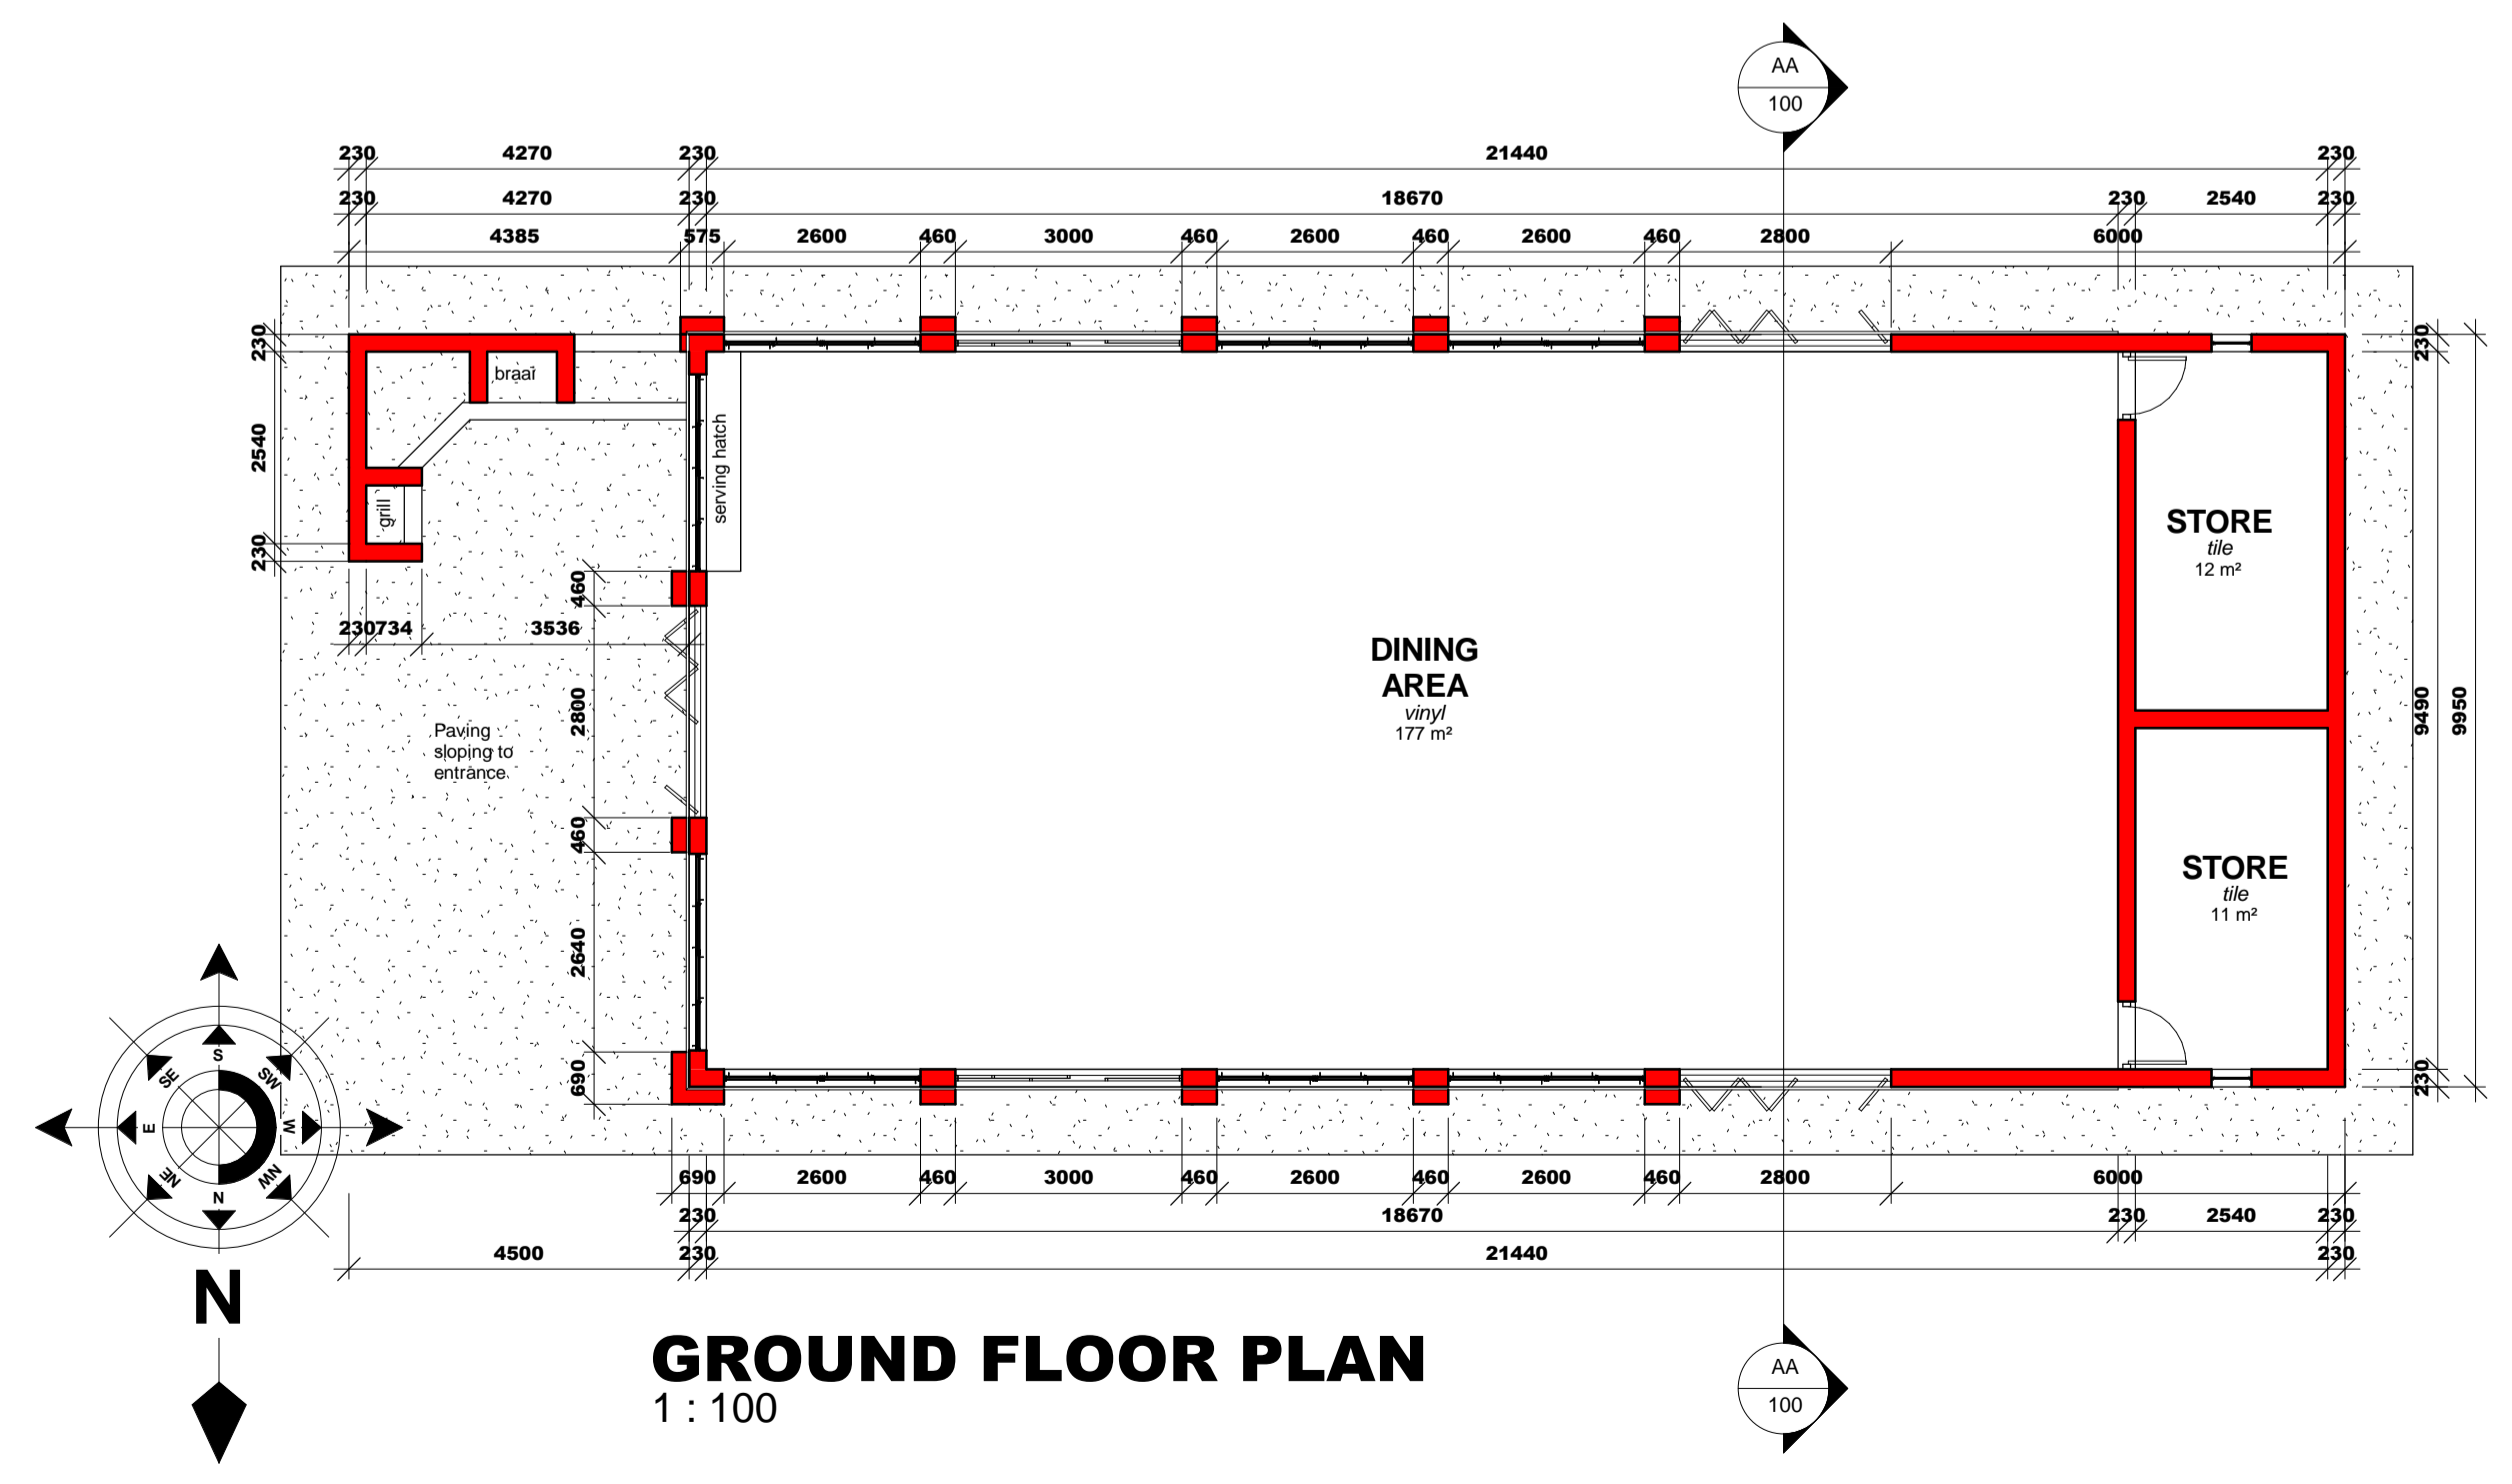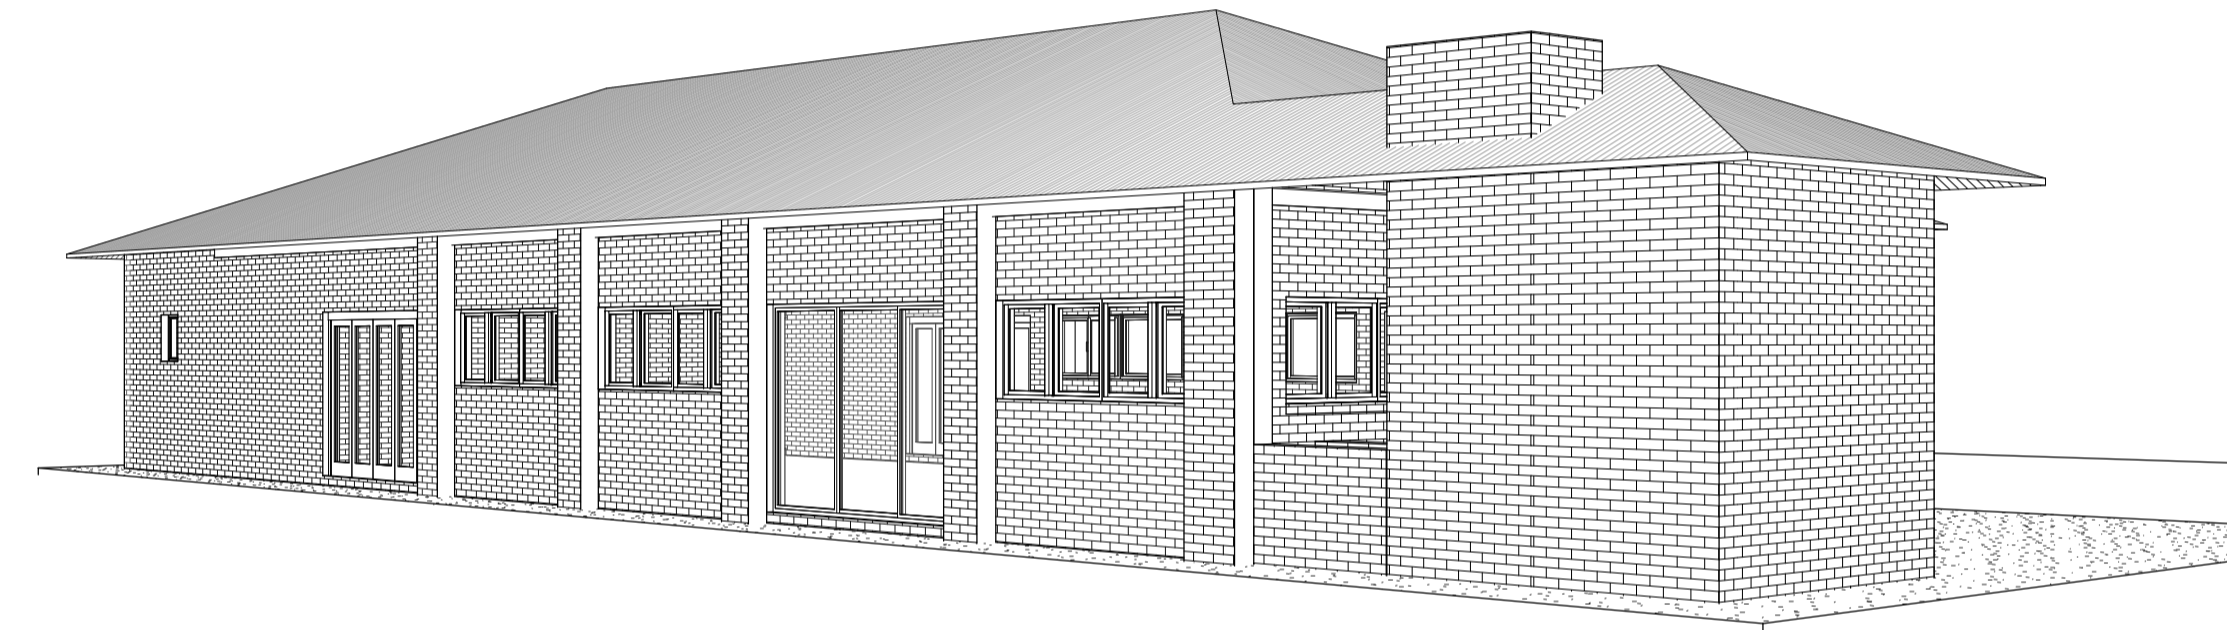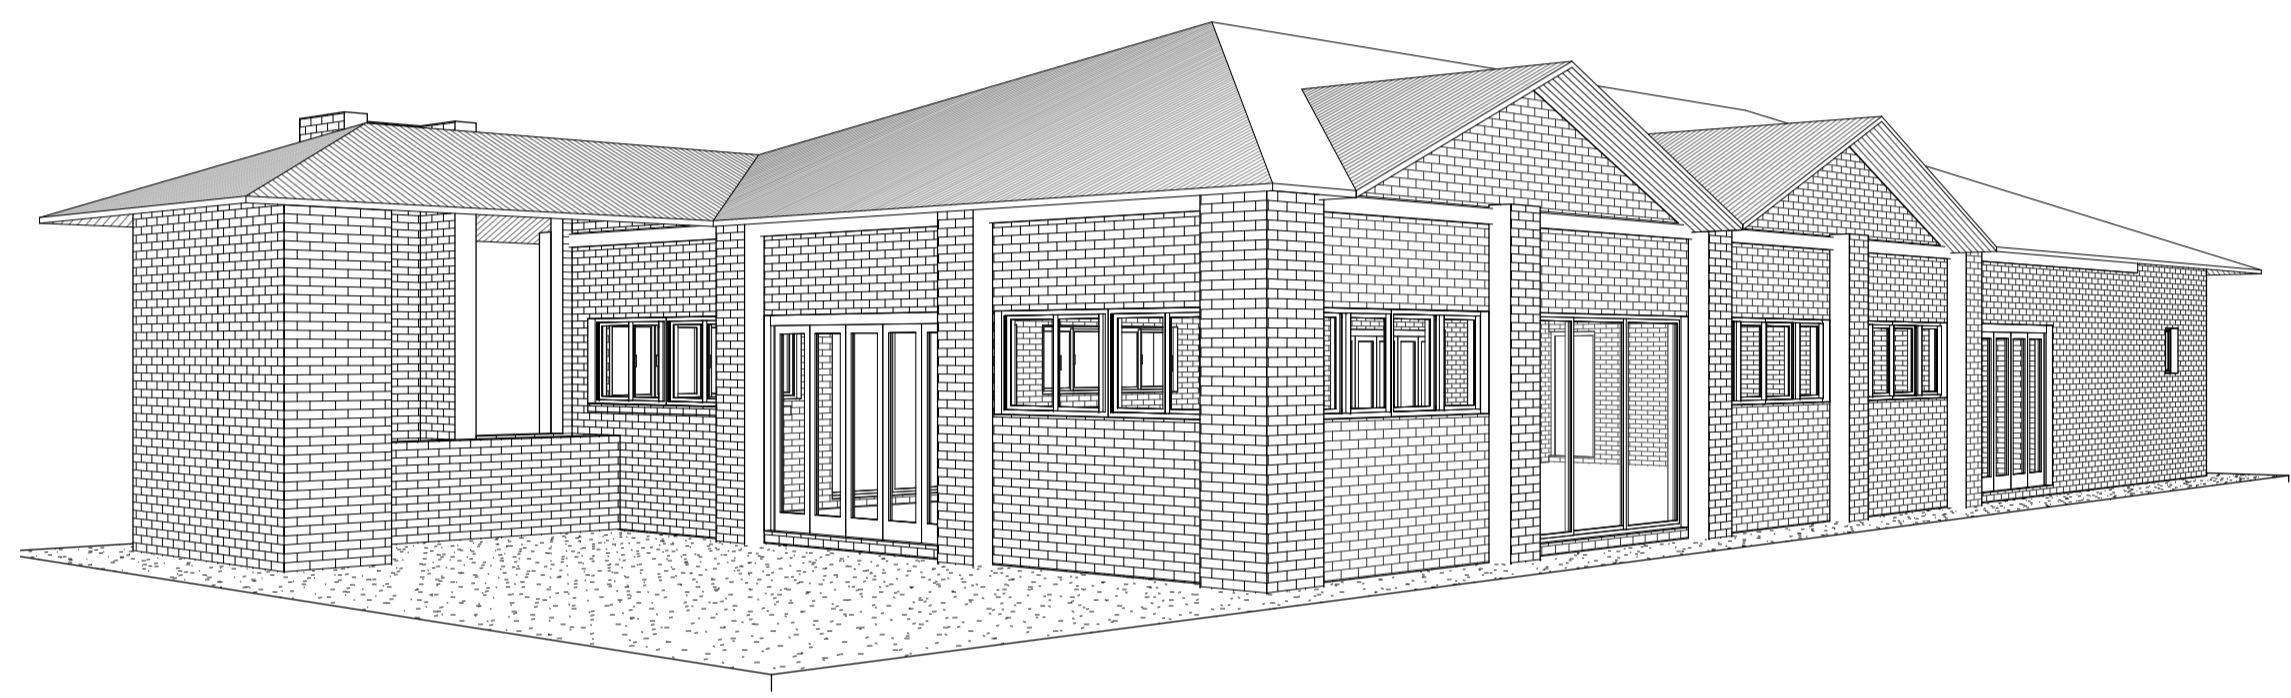

**GROUND FLOOR PLAN**  
1 : 100

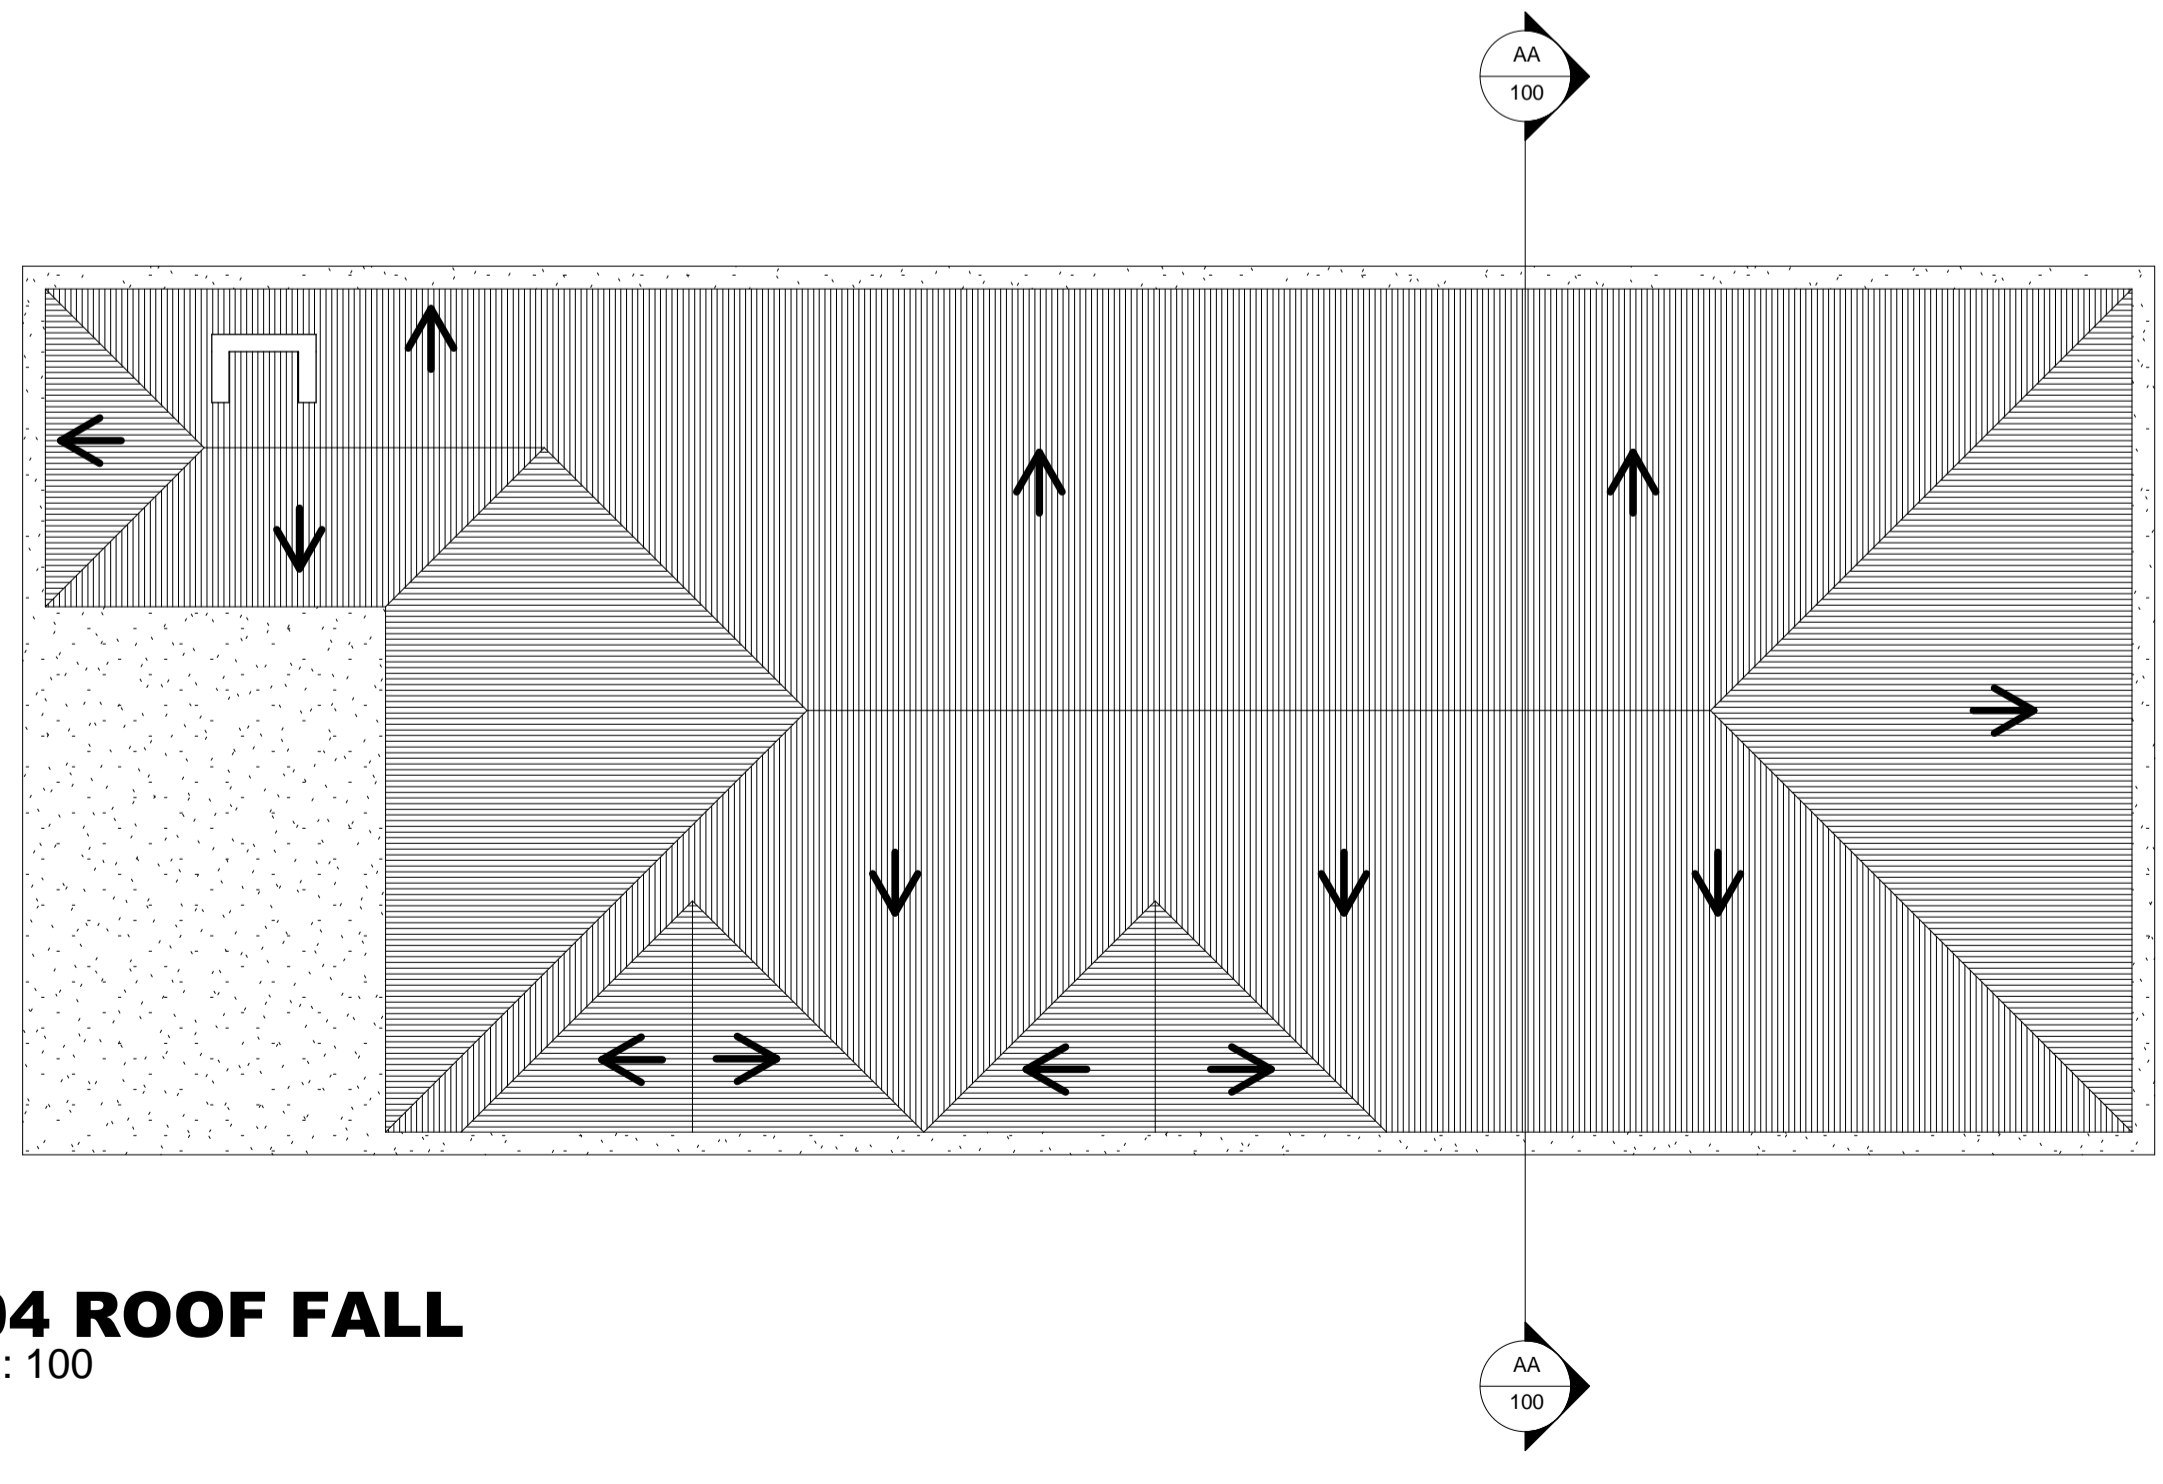

**04 ROOF FALL**  
1 : 100

**NOTES:**

cad file name  
REVIT 2013

REVISIONS DURING CONSTRUCTION		
NO	DATE	AMENDMENT

ISSUED FOR:	
Information	Construction
Tender-Contract	Client Approval
Measurement	Municipal Approval

REVISIONS PRIOR CONSTRUCTION		
NO	DATE	AMENDMENT

CONTRACTOR TO VERIFY ALL LEVELS, HEIGHTS & DIMENSIONS ON SITE PRIOR TO COMMENCEMENT OF WORK.  
DO NOT SCALE DRAWINGS.  
COPYRIGHT RESERVED BY ARCHITECT.



MPMHA BUILDING AND PROJECTS 1 cc  
Contact: 082 639 0982  
Email: tskyber@gmail.com

Client  
**the gpaa**  
Department: Government Pensions Administration Agency  
REPUBLIC OF SOUTH AFRICA

Client project number

Project Title  
**KITCHEN & DINING AS-BUILT DRAWING**

Site Information  
**GPAA PRETORIA**

Project Architect

Project Co-ordinator/ Manager

Project Architectural Technician  
Thabiso Sekiba

Drawing title  
**PLANS, SECTION, ELEVATIONS**

Project No 2016G	Drawing No 100	Project Stage 4	Drawing Revision
---------------------	-------------------	--------------------	------------------

Scale 1 : 100	Drawn <b>TS</b>	Checked <b>RDM</b>
------------------	--------------------	-----------------------

First Issue Date 2016/06/28	Latest Issue Date 2016/06/28 12:00:03 AM
--------------------------------	--